

SUITE: 1100

RSF: 19,995



The
WESTERN PACIFIC
ON BROADWAY

AS-BUILT CONFIGURATION

OFFICES.....	18
RECEPTION.....	N/A
CONFERENCE ROOMS.....	57
KITCHEN.....	1
OPEN WORK AREA.....	+/- 102

Not to scale, furniture and appliances not included

KEY PLAN

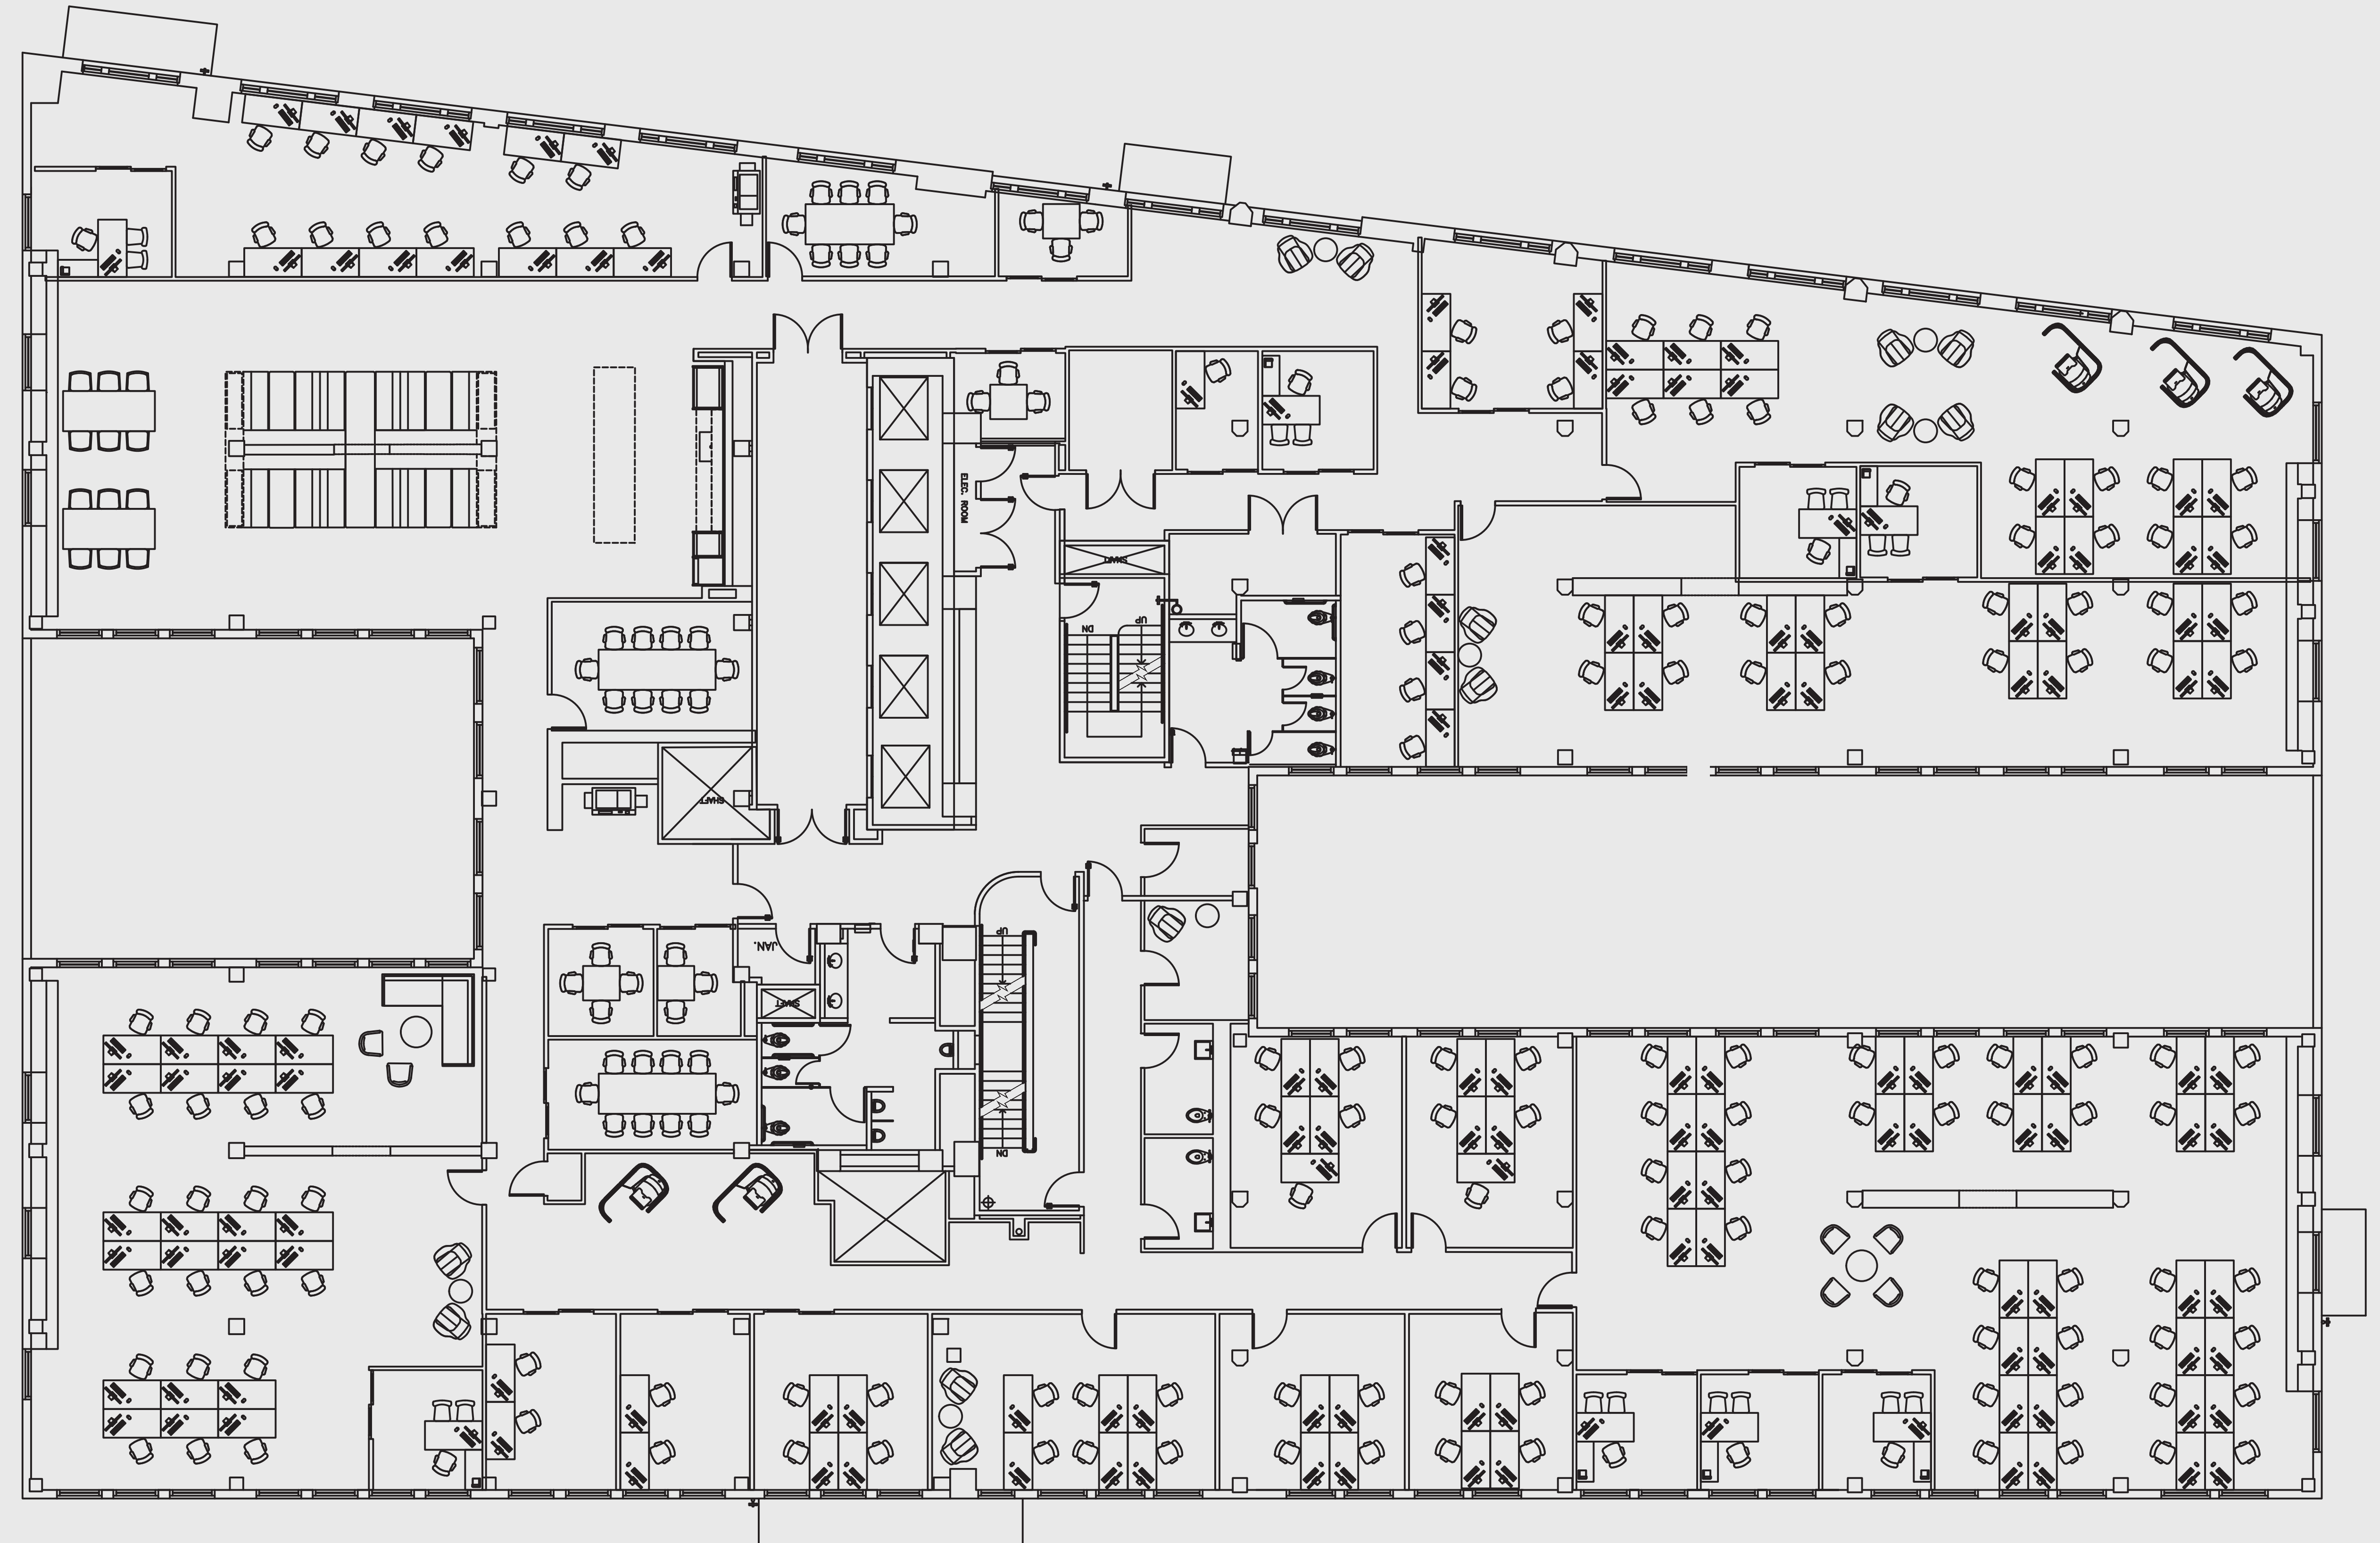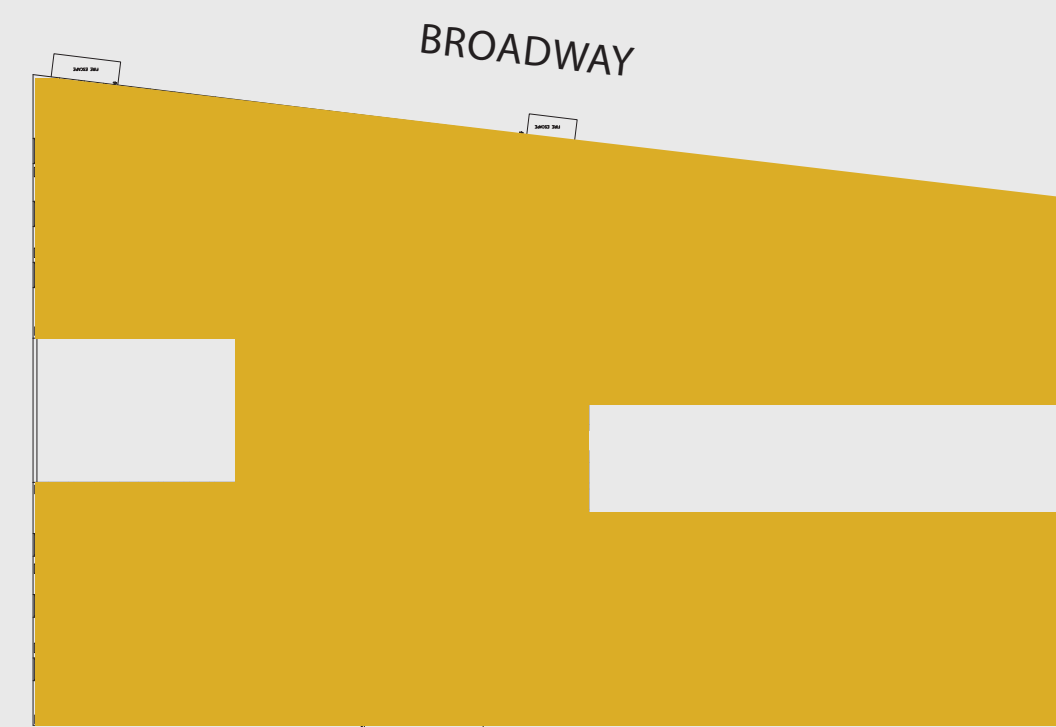

For leasing information please contact:
Steve Bernier
213.908.1250 | sbernier@onni.com

Neal Linthicum
310.427.1314 | nlinthicum@onni.com

