

SUITE: 1200

RSF: 19,701



The
WESTERN PACIFIC
ON BROADWAY

AS-BUILT CONFIGURATION

OFFICES.....	12
RECEPTION.....	1
CONFERENCE ROOMS.....	3
KITCHEN.....	1
OPEN WORK AREA.....	+/- 94

Not to scale, furniture and appliances not included

KEY PLAN

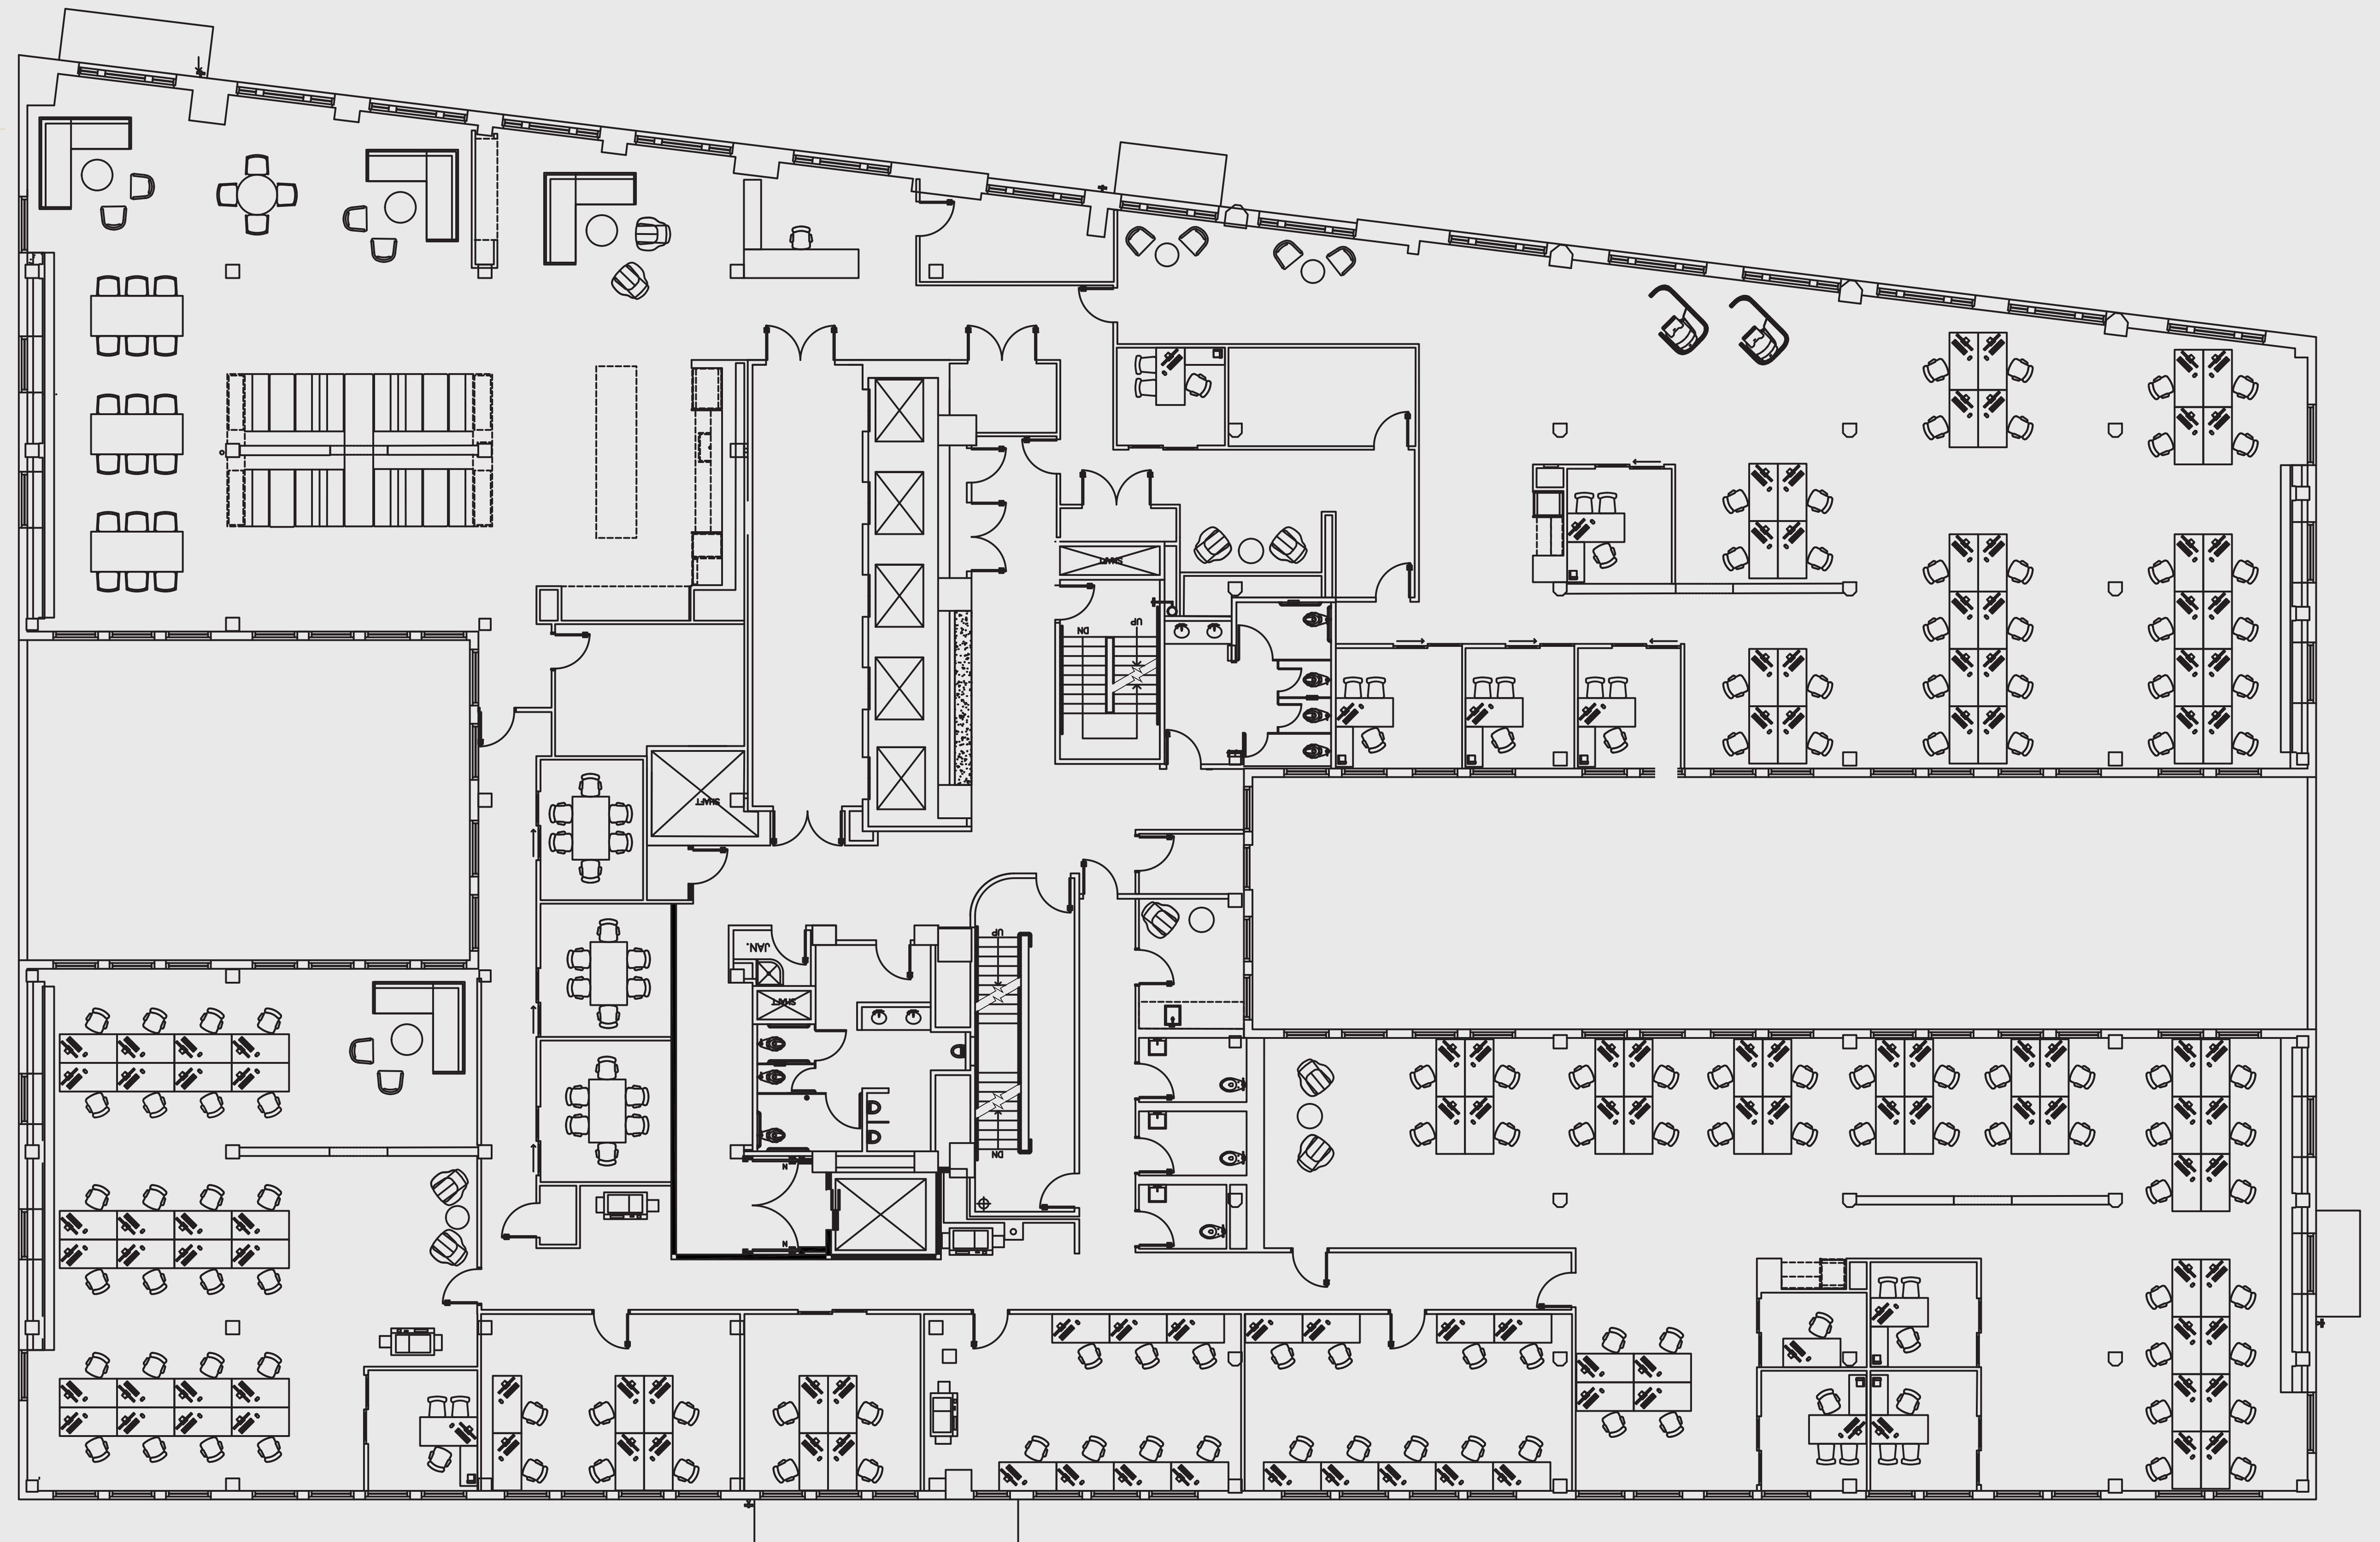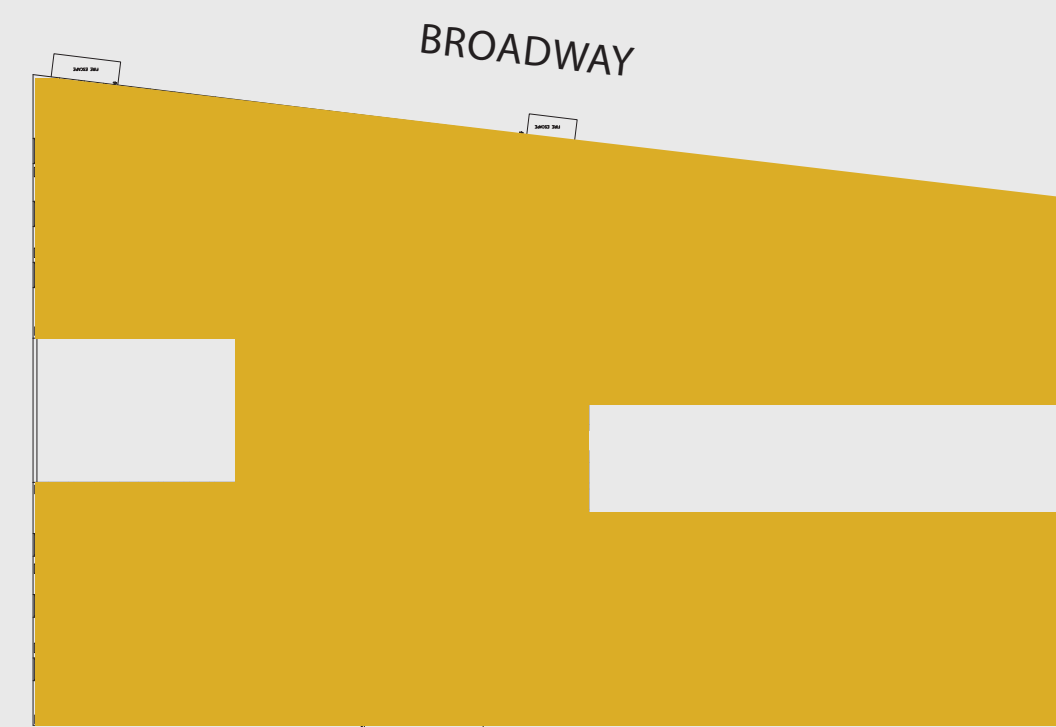

For leasing information please contact:
Steve Bernier
213.908.1250 | sbernier@onni.com

Neal Linthicum
310.427.1314 | nlinthicum@onni.com

