

SUITE:275

RSF: 9,063



The
WESTERN PACIFIC
ON BROADWAY

AS-BUILT CONFIGURATION

OFFICES.....	9
RECEPTION.....	1
CONFERENCE ROOMS.....	3
KITCHEN.....	1
OPEN WORK AREA.....	+/-59

Not to scale, furniture and appliances not included

KEY PLAN

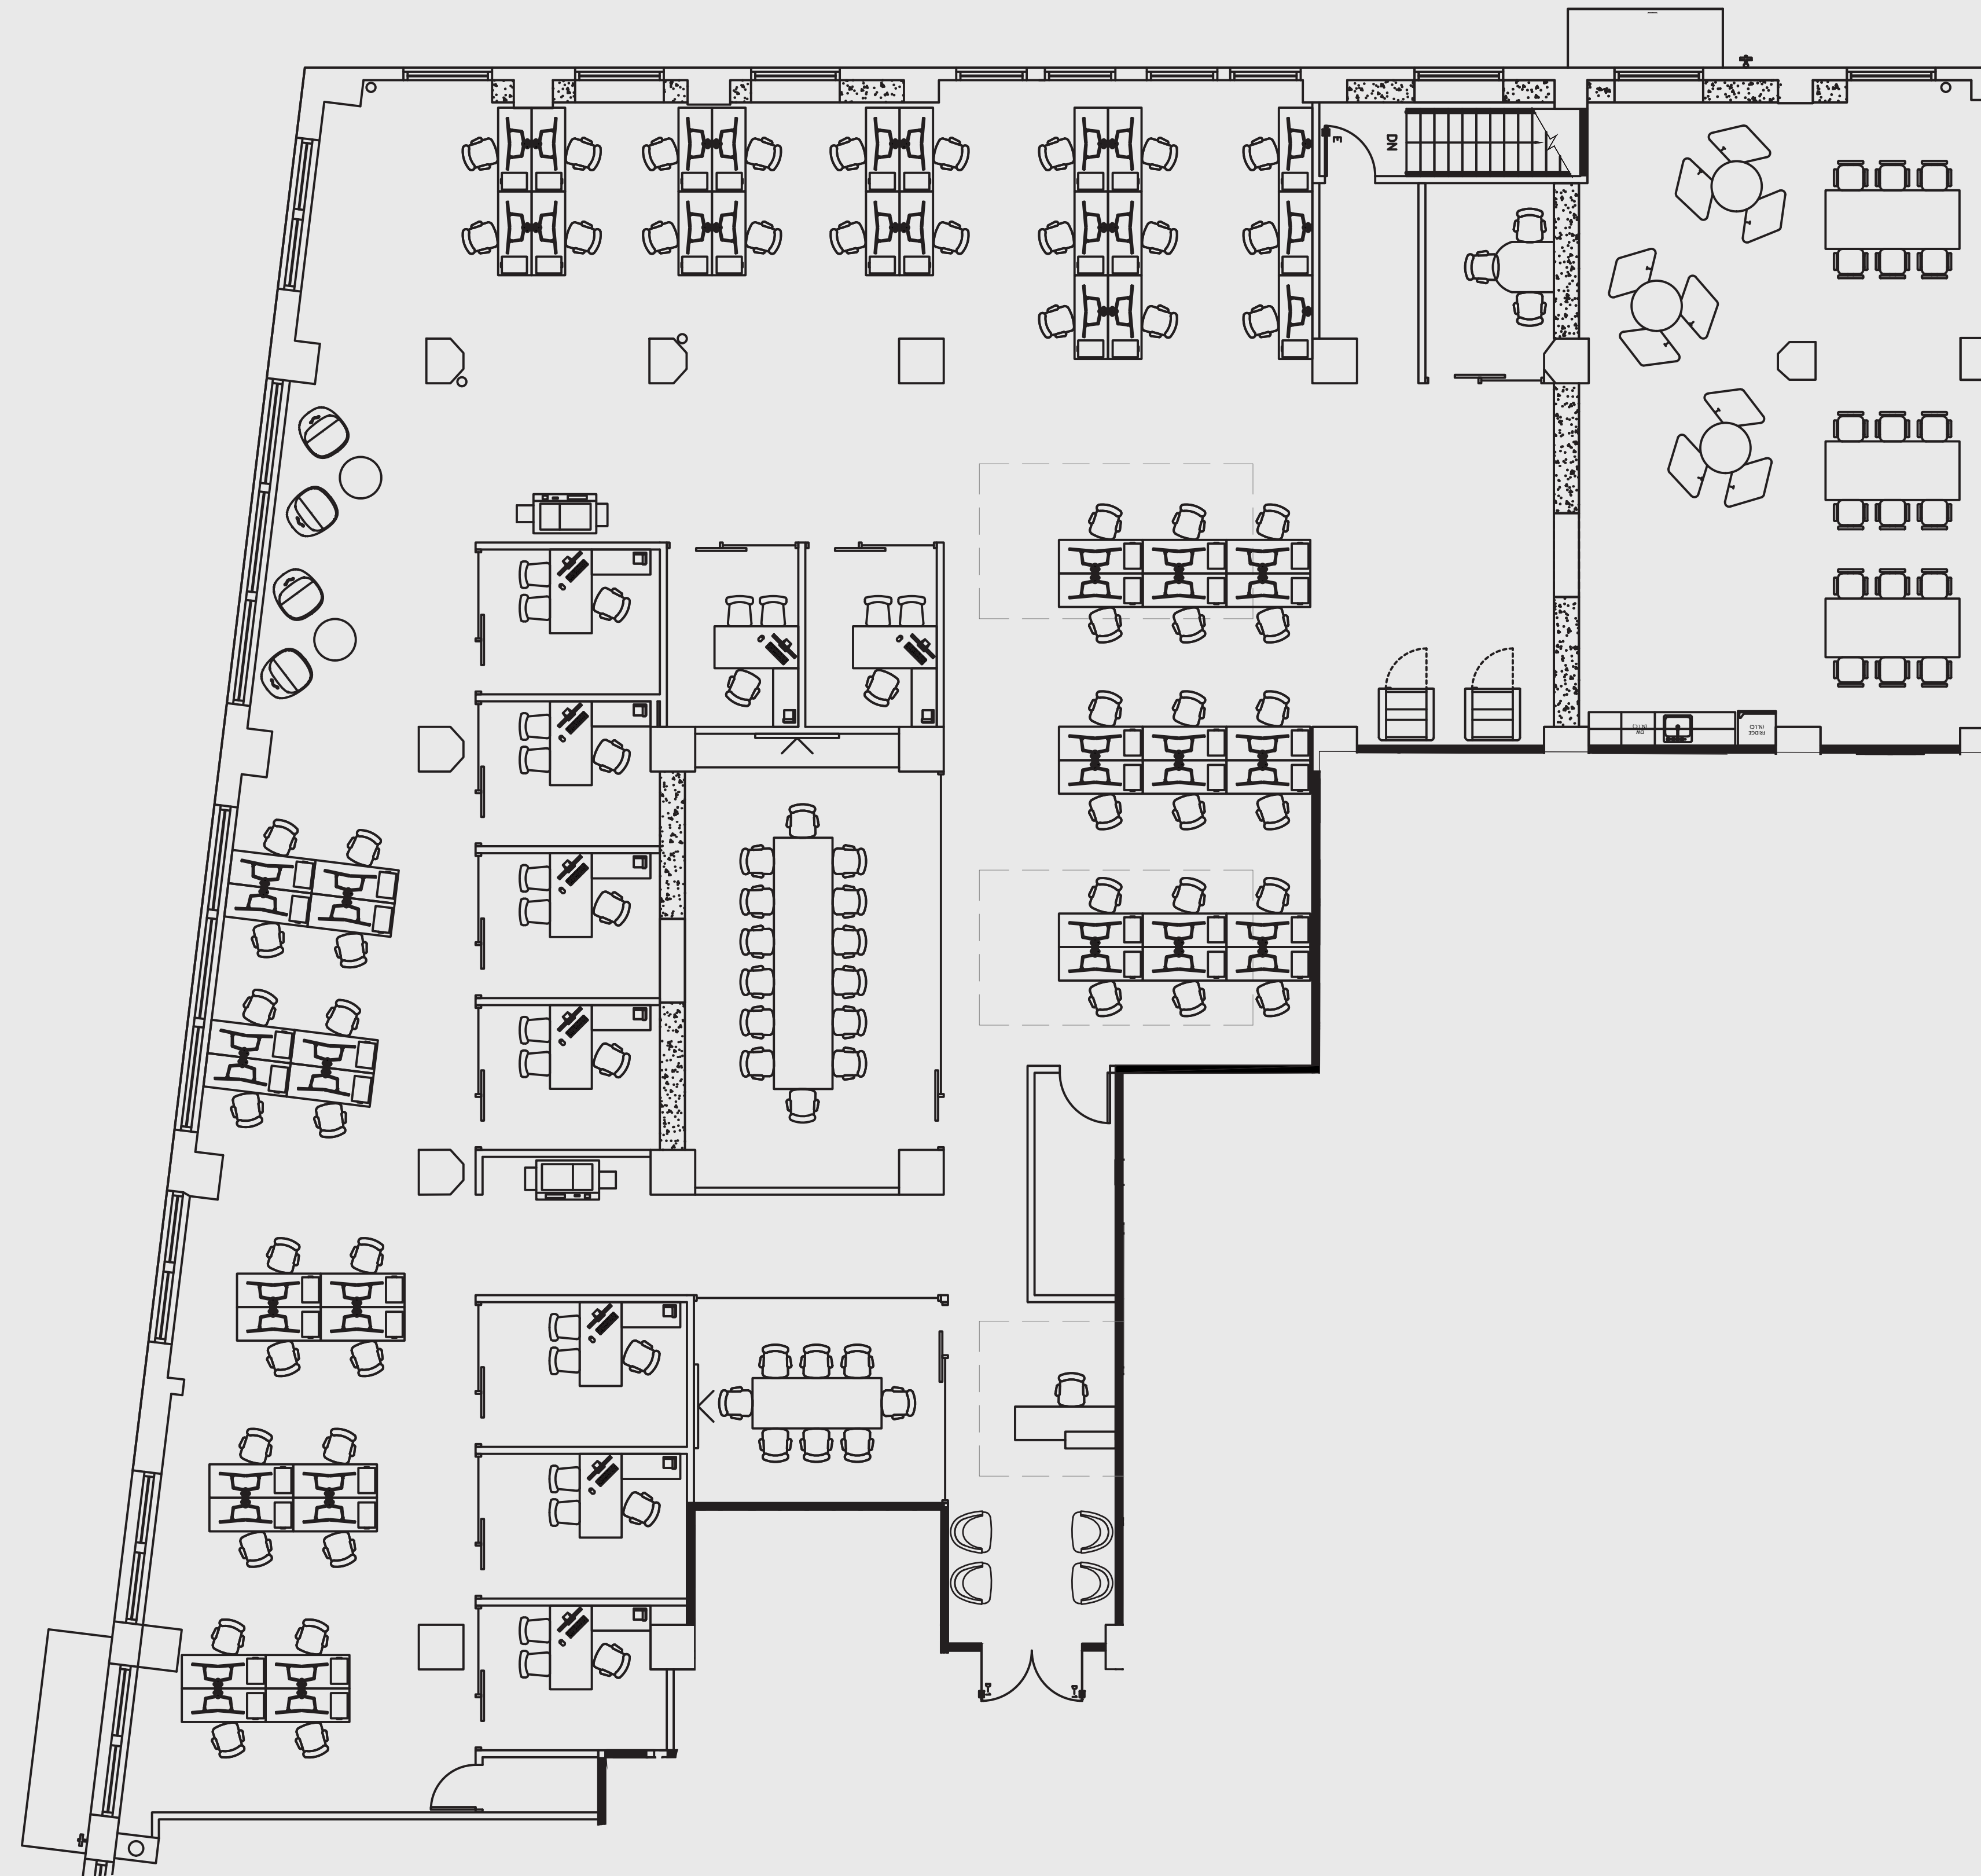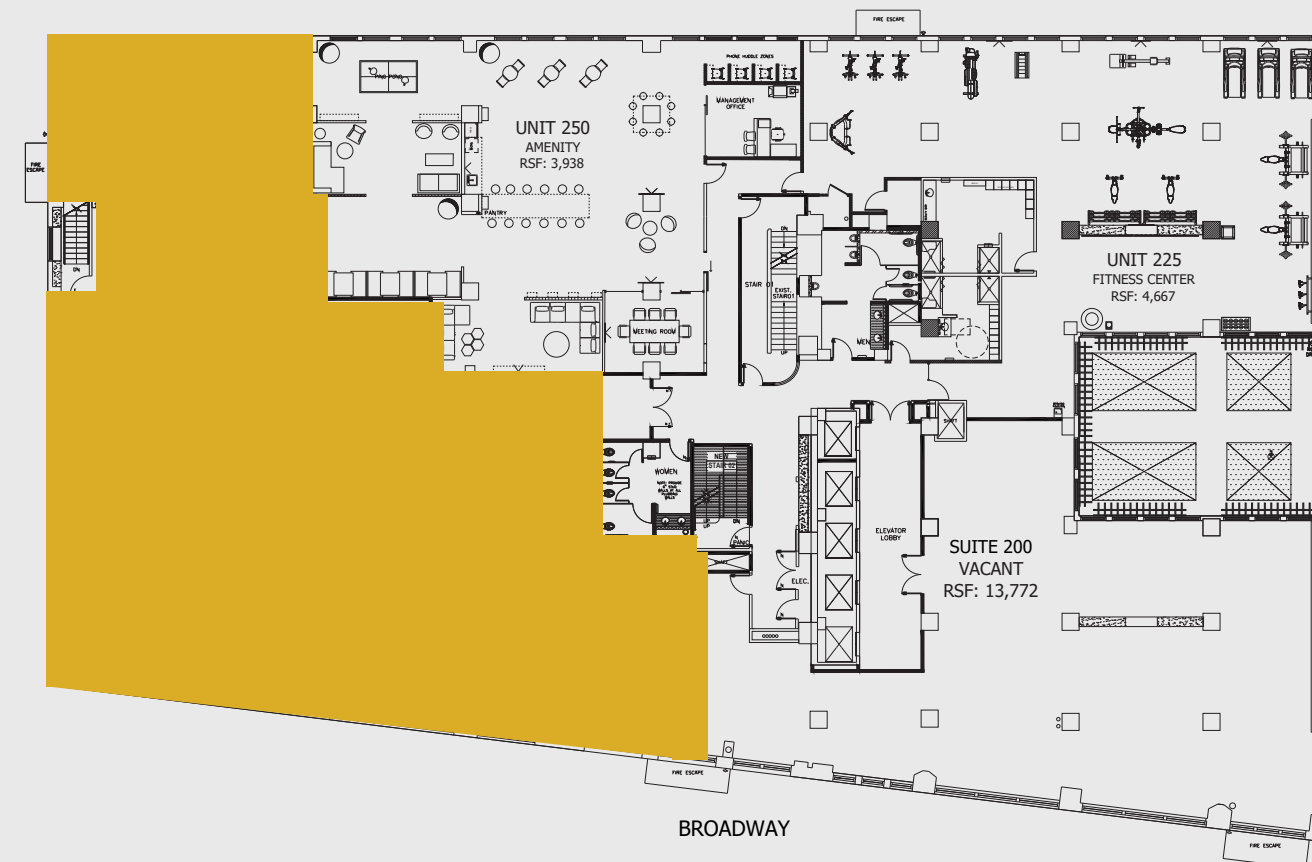

For leasing information please contact:
James Malone
213.239.6021 | james.malone@am.jll.com

Dana Vargas
213.239.6121 | dana.vargas@am.jll.com

Peter Hajimihalis
213.239.6399 | peter.hajimihalis@am.jll.com

