

SUITE:300

RSF: 4,509

The
WESTERN PACIFIC


ON BROADWAY

AS-BUILT CONFIGURATION

OFFICES.....	3
RECEPTION.....	1
CONFERENCE ROOMS.....	1
KITCHEN.....	1
OPEN WORK AREA.....	+/-38

Not to scale, furniture and appliances not included

KEY PLAN

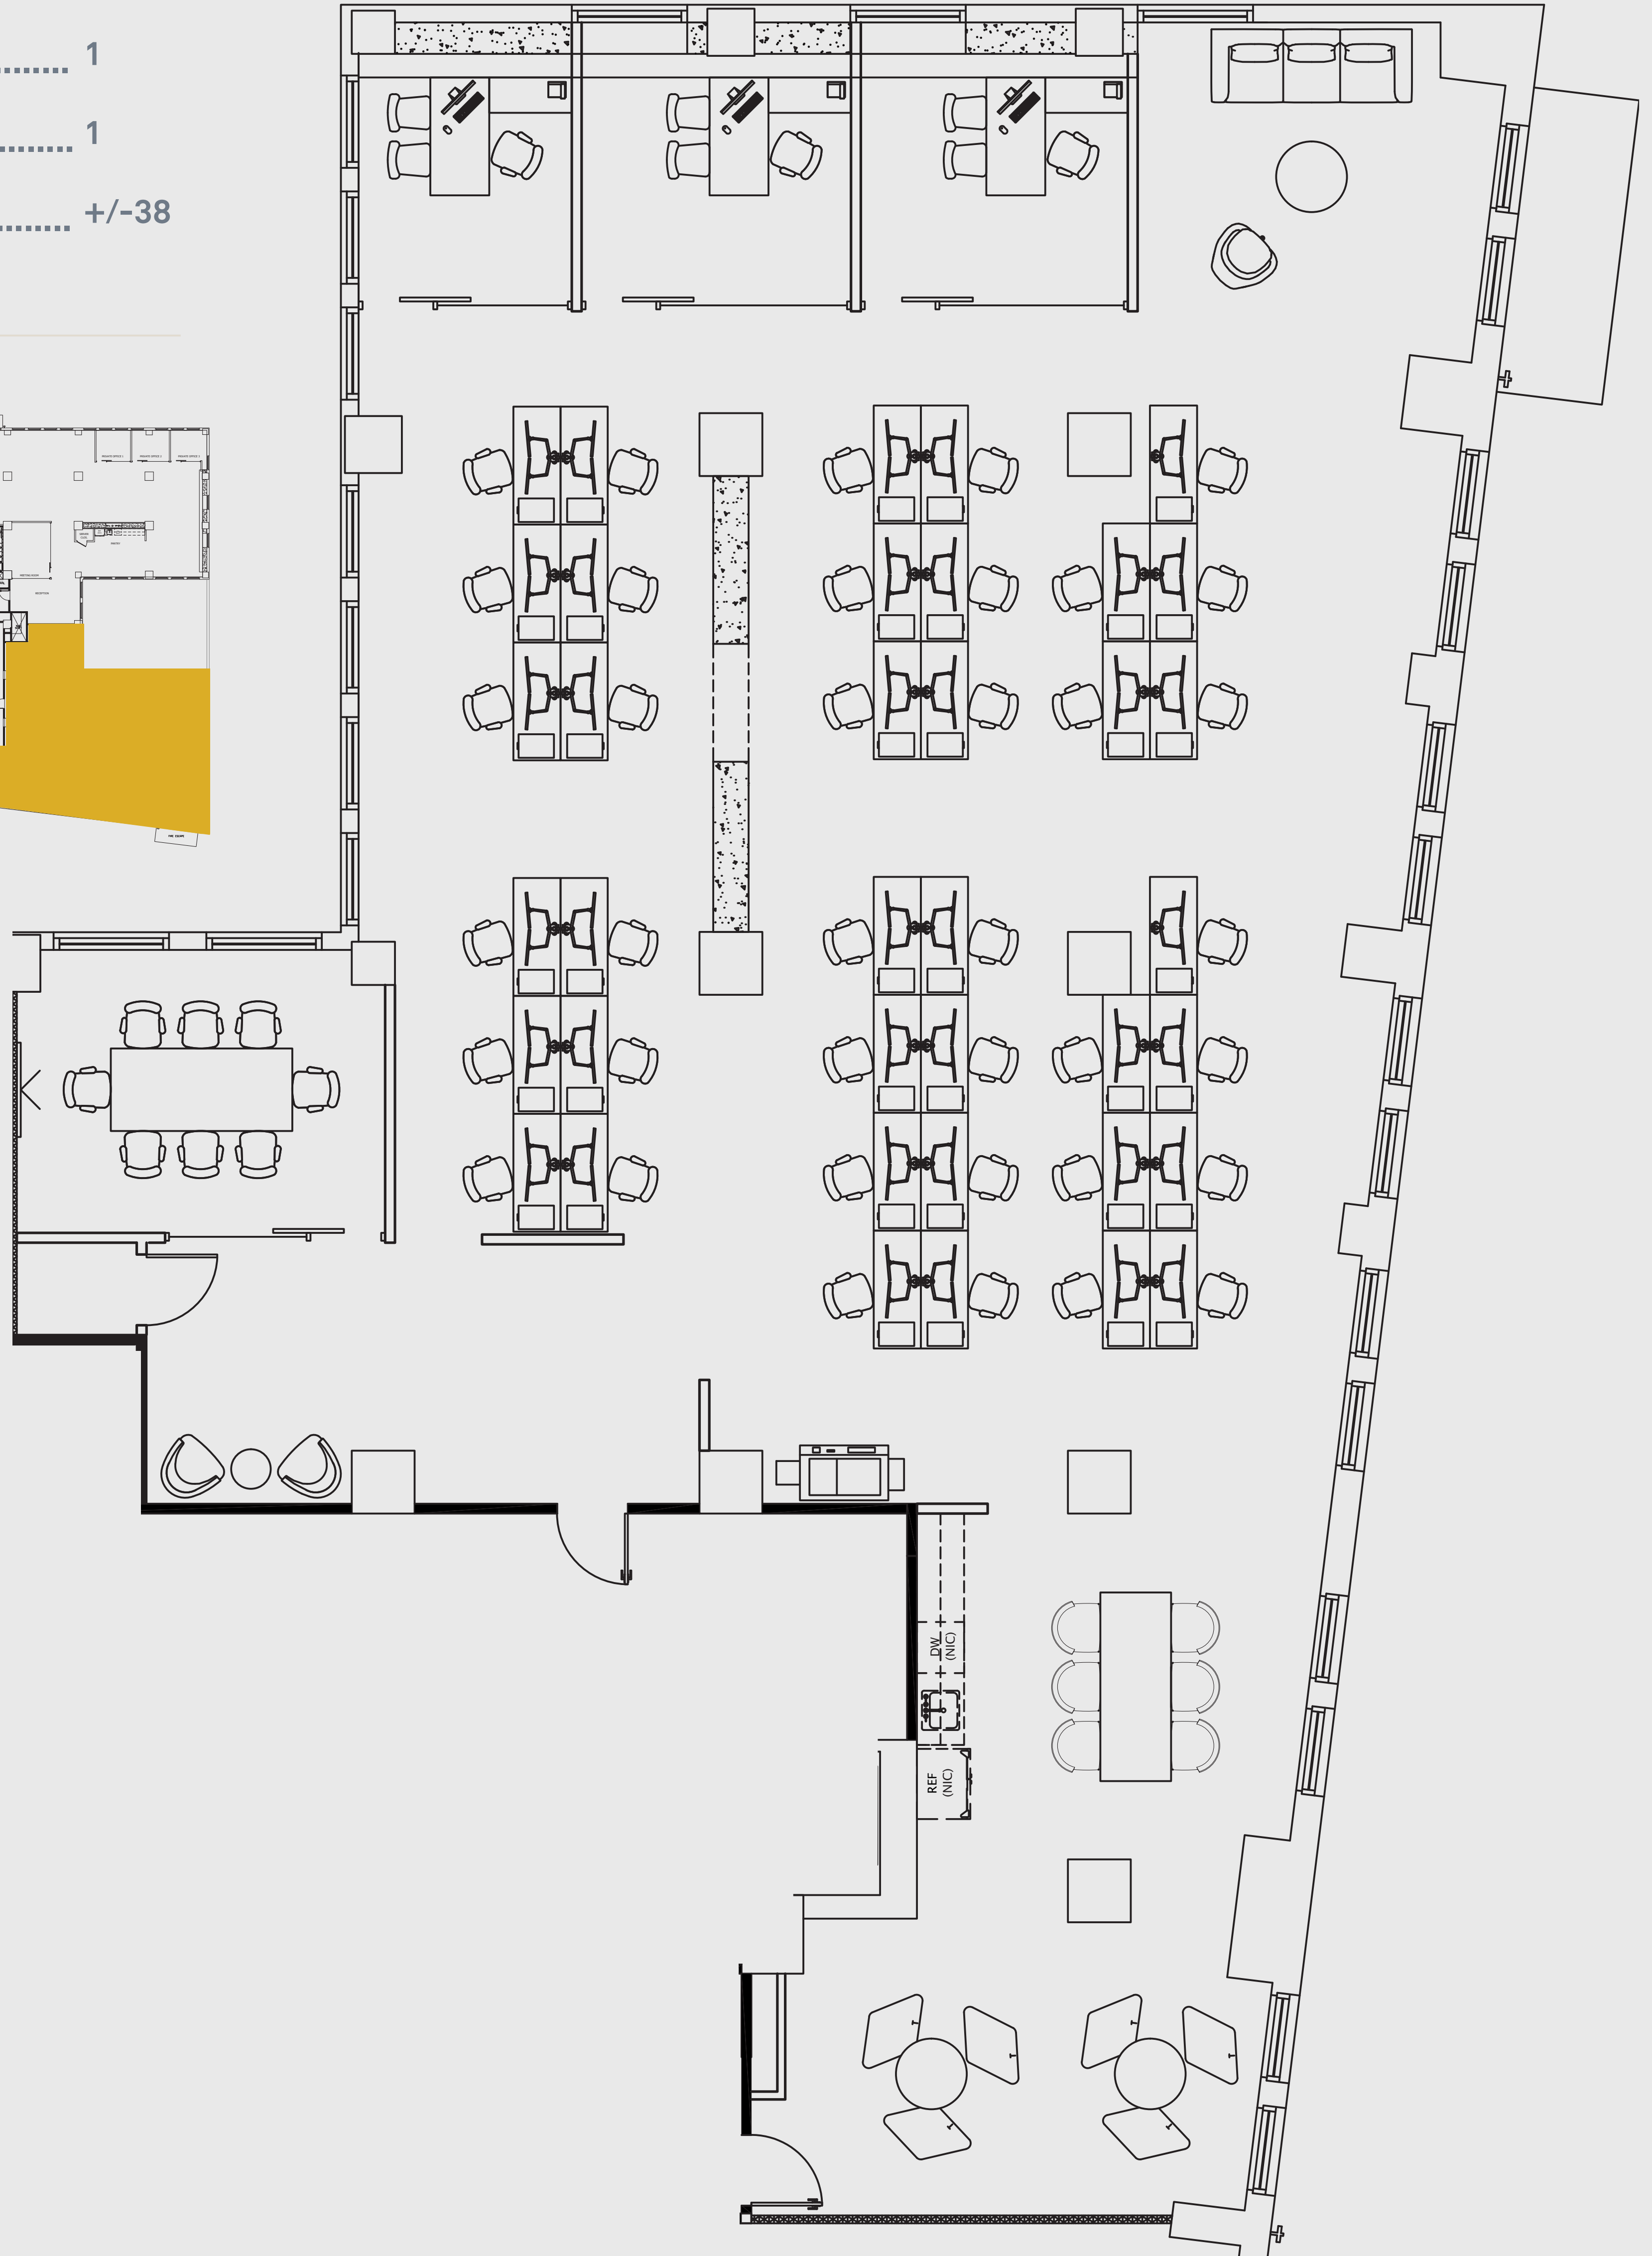

For leasing information please contact:
James Malone
213.239.6021 | james.malone@am.jll.com

Dana Vargas
213.239.6121 | dana.vargas@am.jll.com

Peter Hajimihalis
213.239.6399 | peter.hajimihalis@am.jll.com

