

SUITE: 510



RSF: 10,394

AS-BUILT CONFIGURATION

OFFICES.....	TBD
RECEPTION.....	TBD
CONFERENCE ROOMS.....	TBD
KITCHEN.....	TBD
OPEN WORK AREA.....	TBD

Not to scale, furniture and appliances not included

KEY PLAN

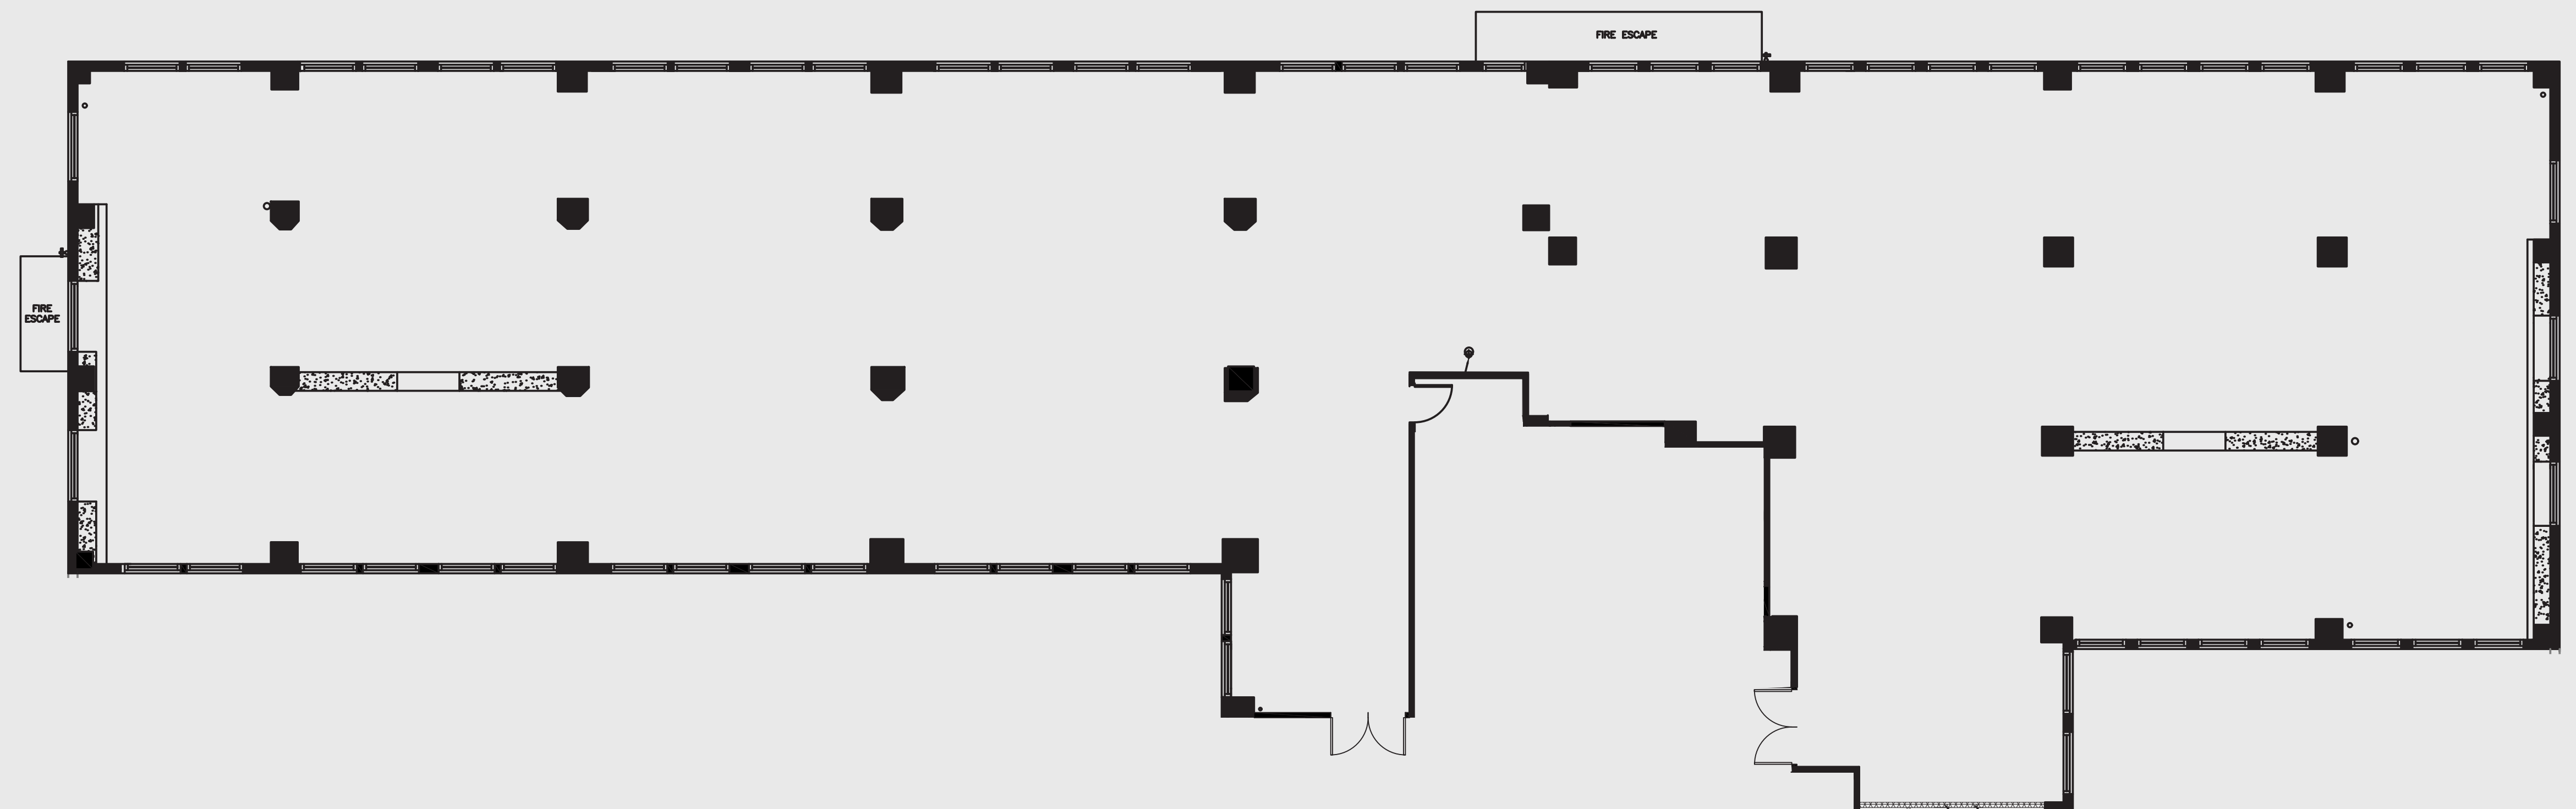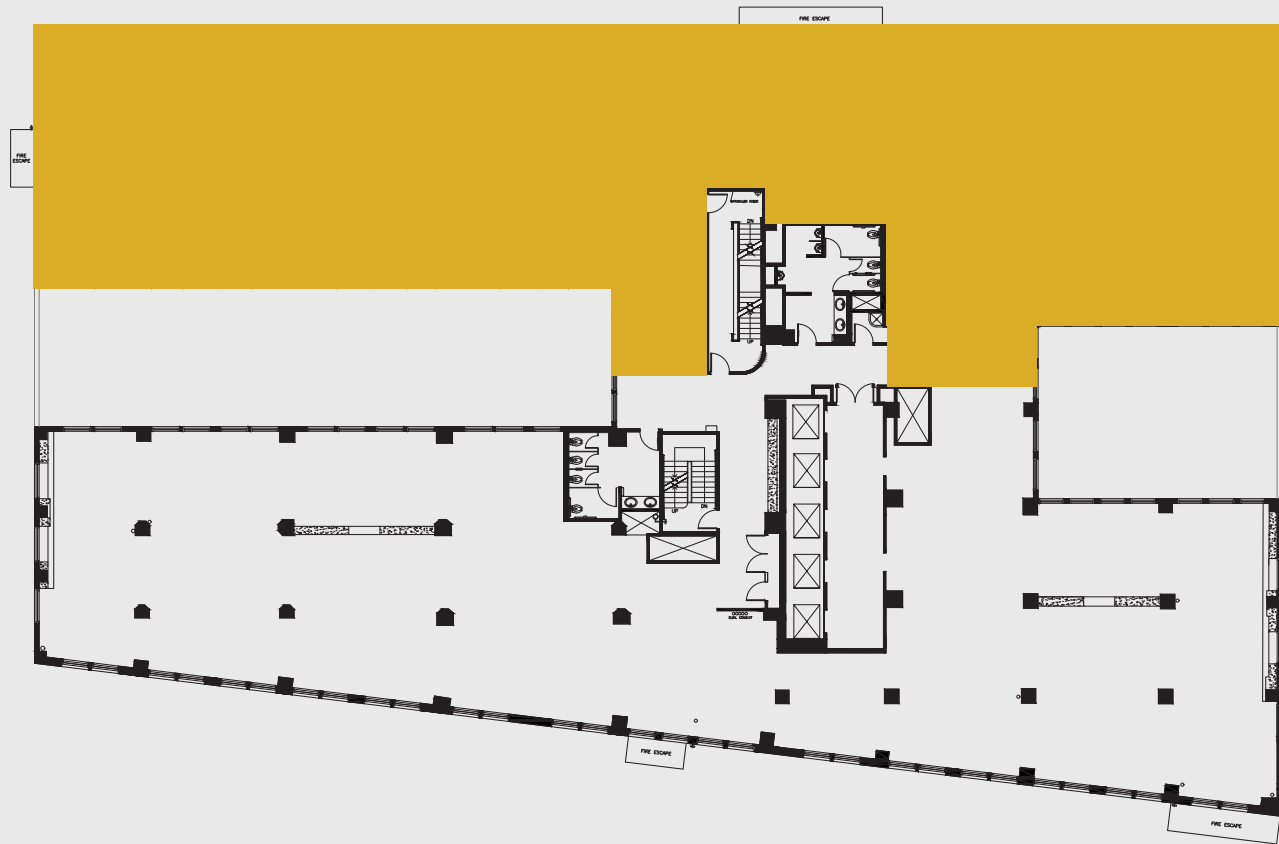

For leasing information please contact:
USALEASING@ONNI.COM
(213) 629-2041