

# SUITE: 600

# RSF: 20,102

*The*  
**WESTERN PACIFIC**  
ON BROADWAY

## AS-BUILT CONFIGURATION

OFFICES.....TBD

RECEPTION.....TBD



CONFERENCE ROOMS.....TBD

KITCHEN.....TBD

OPEN WORK AREA.....TBD

*Not to scale, furniture and appliances not included*

## KEY PLAN

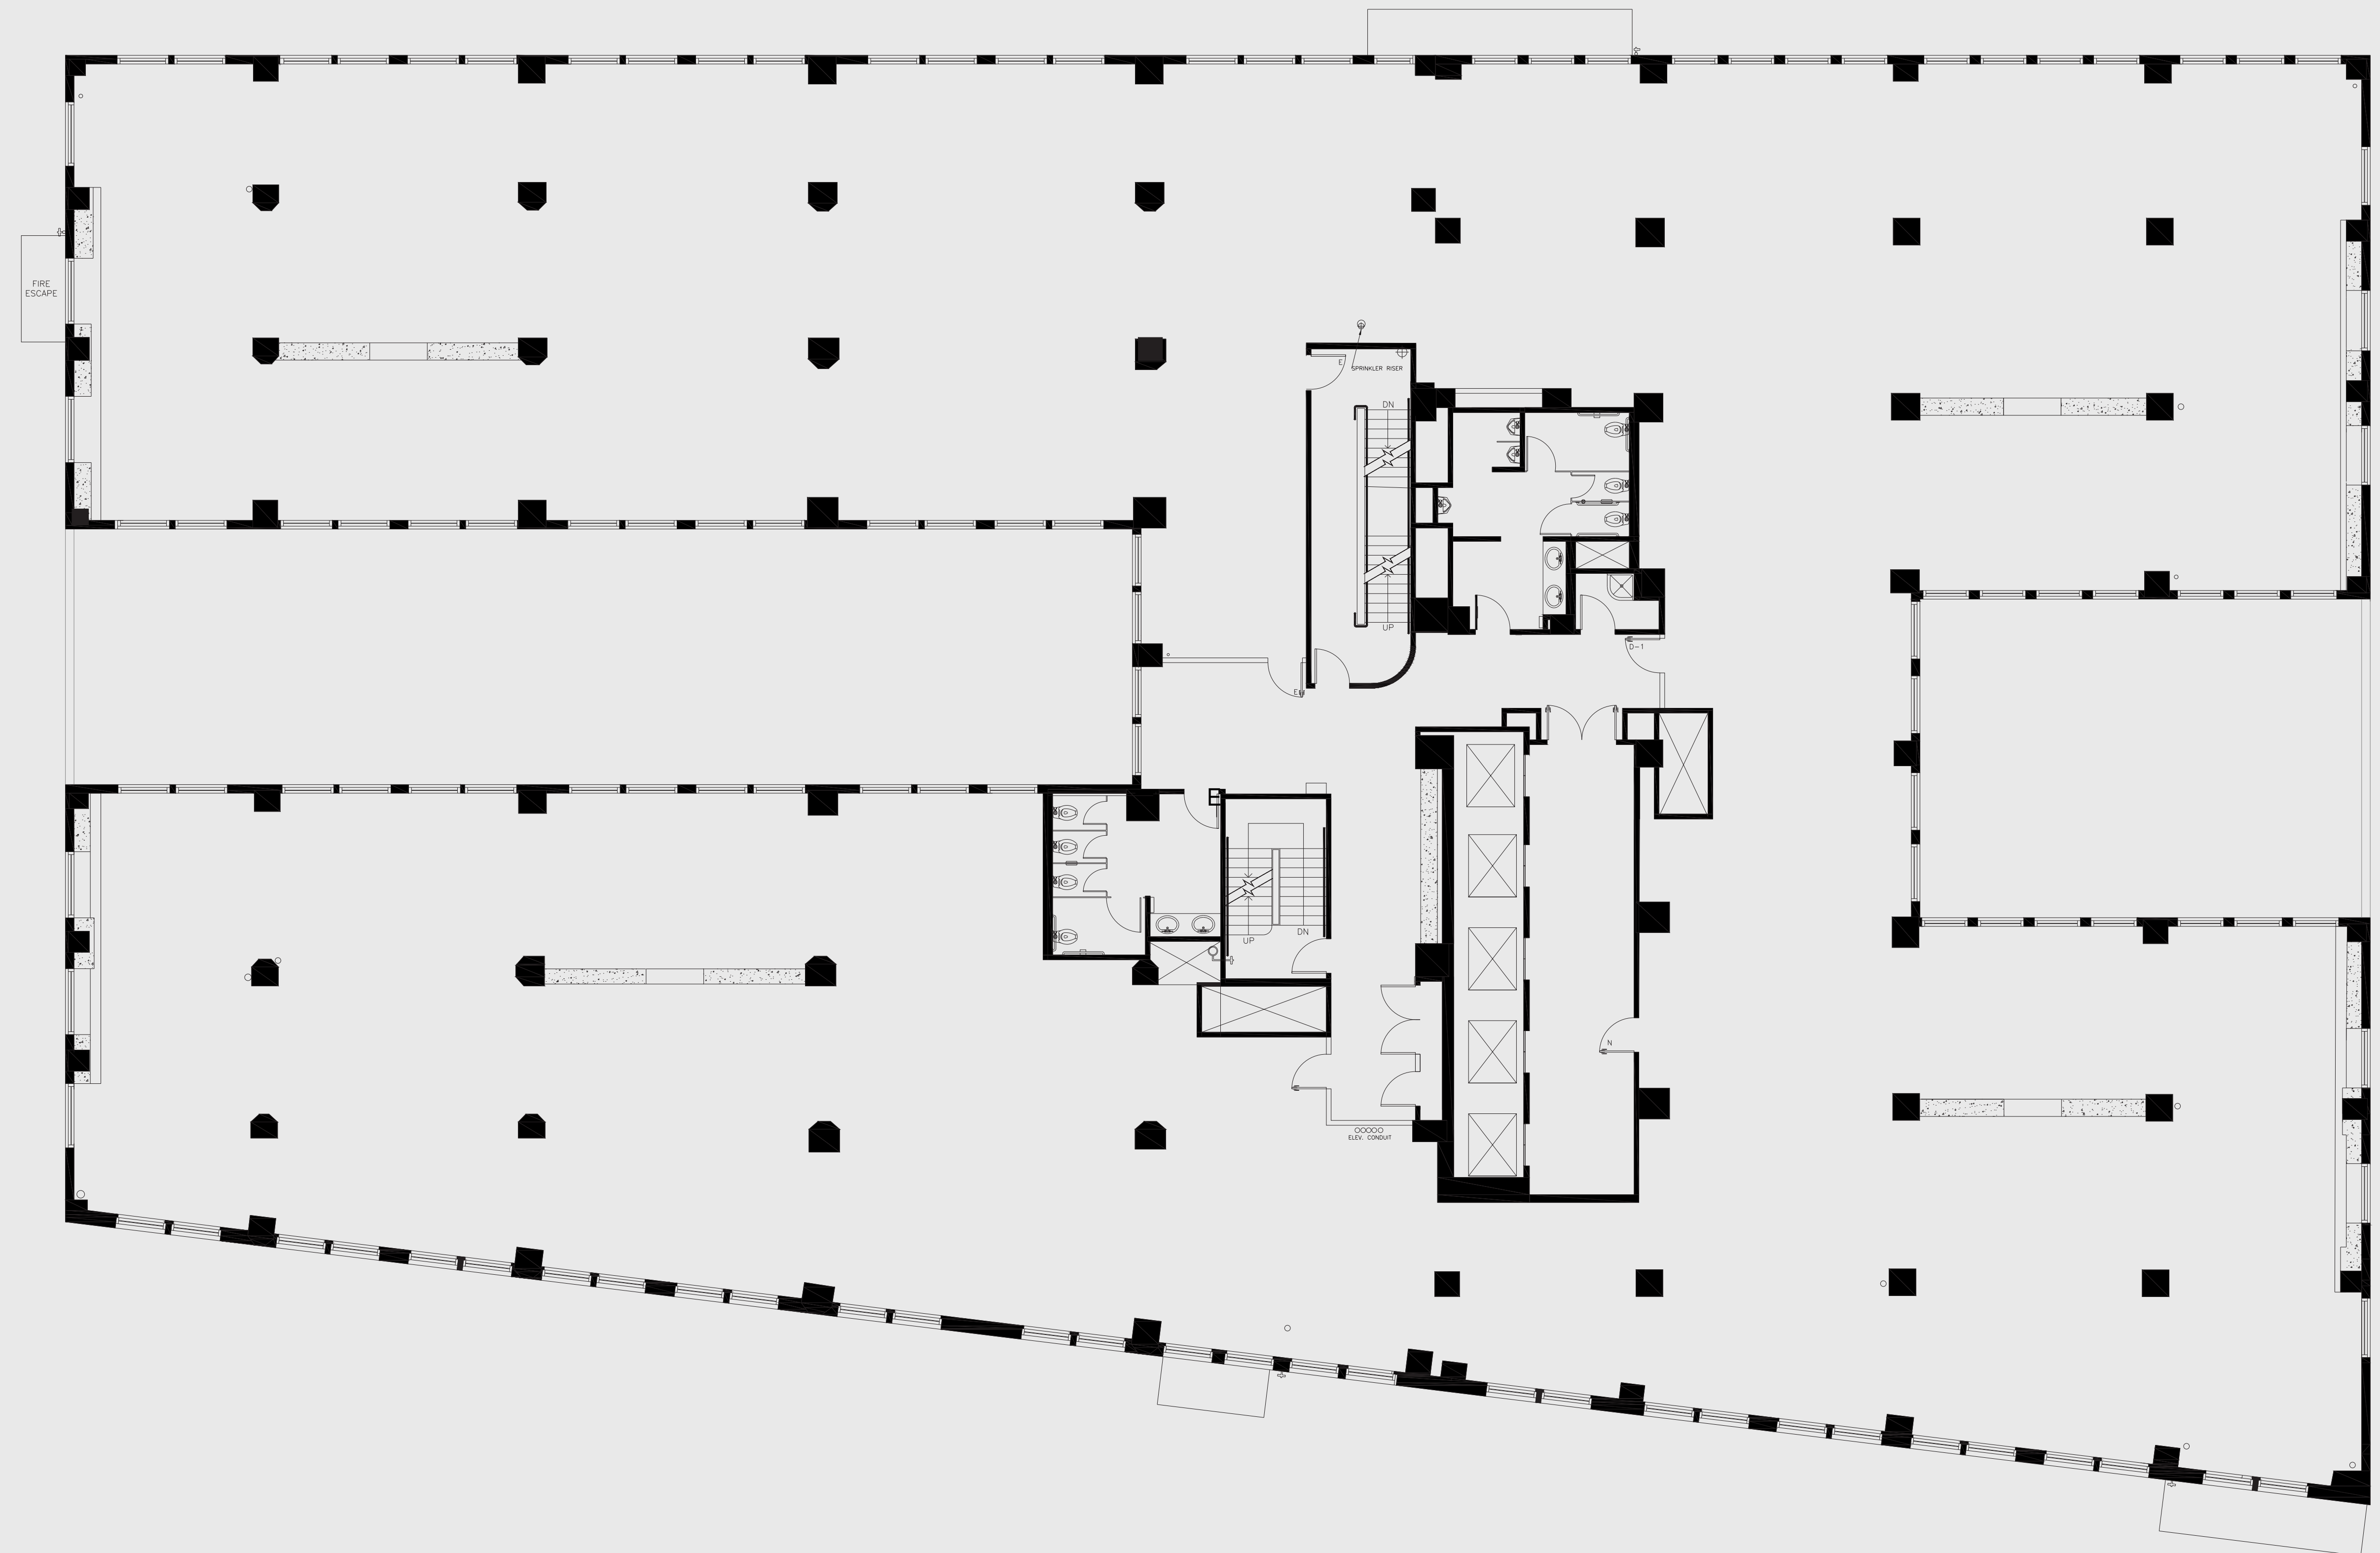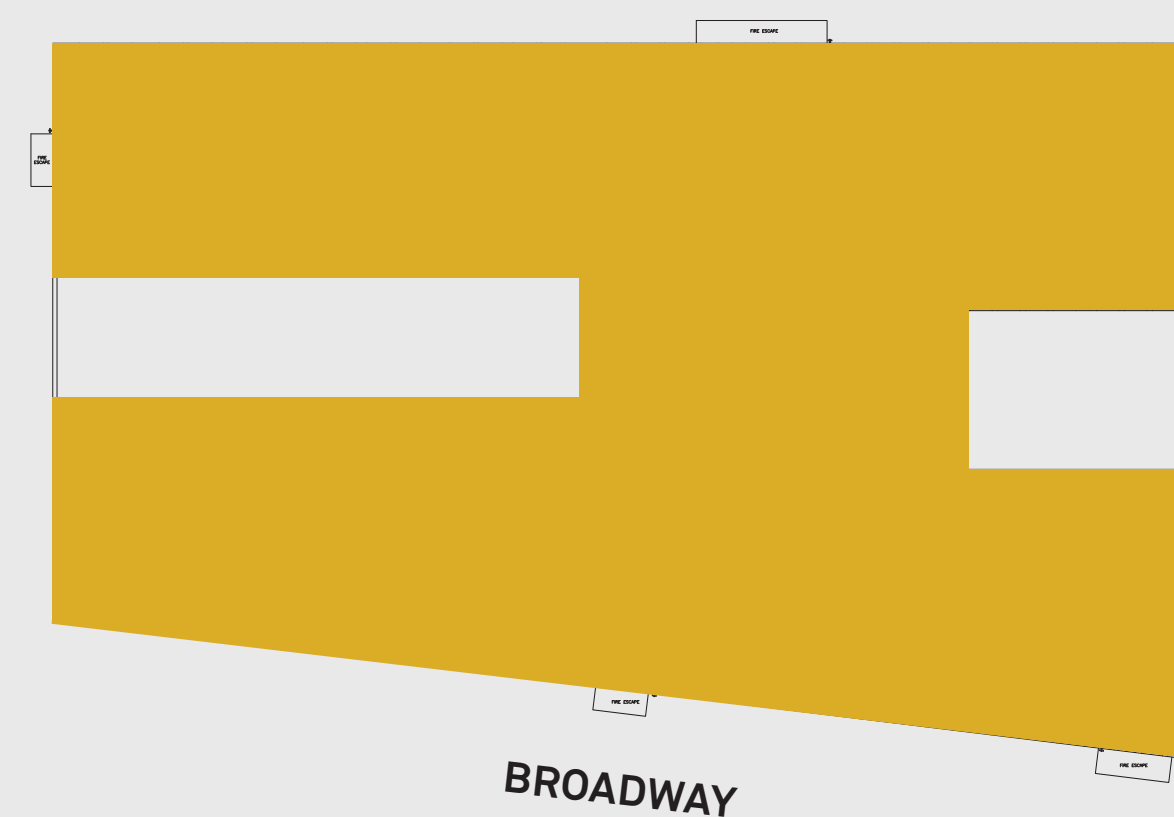

For leasing information please contact:  
James Malone  
213.239.6021 | james.malone@am.jll.com

Dana Vargas  
213.239.6121 | dana.vargas@am.jll.com

Peter Hajimihalis  
213.239.6399 | peter.hajimihalis@am.jll.com

