

SUITE: 375

RSF: 5,286


The
WESTERN PACIFIC
ON BROADWAY

AS-BUILT CONFIGURATION

OFFICES.....	4
RECEPTION.....	1
CONFERENCE ROOMS.....	1
KITCHEN.....	1
OPEN WORK AREA.....	44+

Not to scale, furniture and appliances not included

KEY PLAN

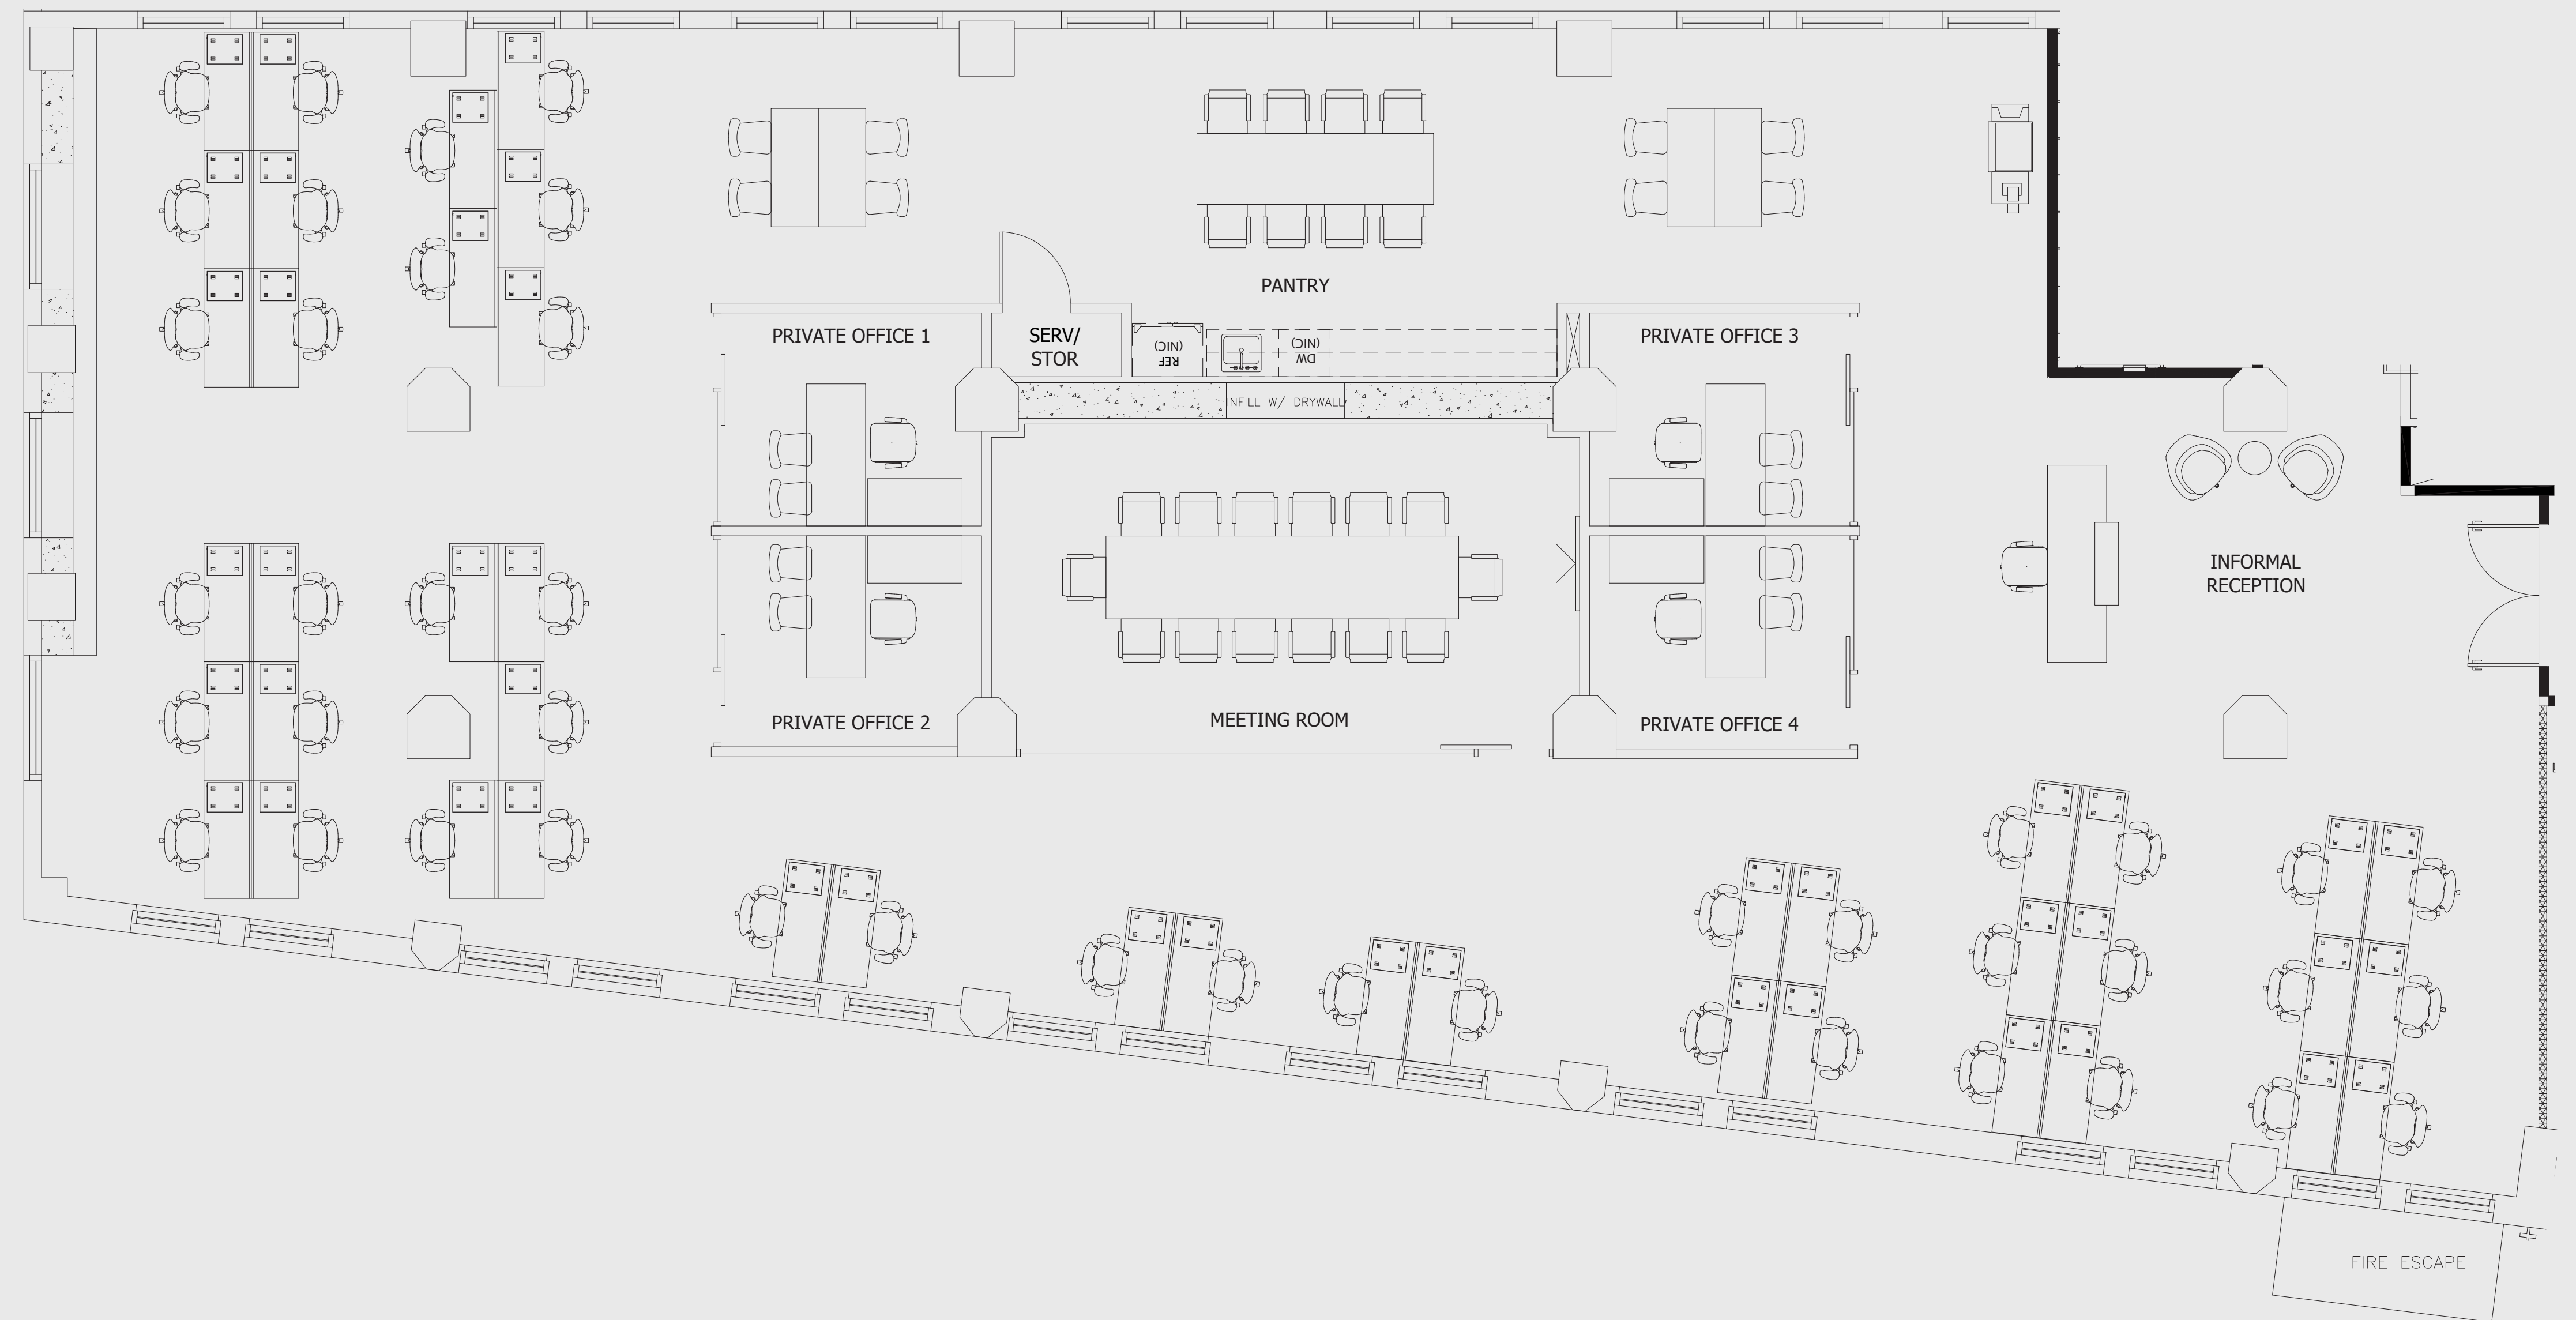

For leasing information please contact:
Andrew D. Tashjian
213.955.5148 | andrew.tashjian@cushwake.com

